

B

Type

Docs

3

Plans

BLD 03-2396

Building Permit Number (List all associated with these documents)

4525

Street Number

SLUSSEK Rd

Street Name

SRO

Community Code

066-280-030

APN

THESE ATTACHMENTS ARE PART OF THE APPROVED PLANS.

- * DO NOT REMOVE THEM ***
- Plan Checklist
 - Energy Conservation Forms LETTER
 - Engineered Details
 - Extracts from Soils Report
 - Fire Marshall Requirements
 - Special Inspection Form
 - See No. 41463
 - KLING STUBBINS LG

PLYWOOD NAILING MUST BE INSPECTED BEFORE COVERING; NAILS STRAIGHT WITH HEADS FLUSH AND FRAGMENTING OUTER PLY. MINIMUM PANEL EDGE DISTANCE.

*** APPROVED ***
 AS NOTED
 PERMIT NO. BLDG-2396 APPROVED BY [Signature]
 PERMIT AND RESOURCE MANAGEMENT DEPARTMENT

APPROVED JOB COPY OF PLANS AND JOB CARDS TO BE ON JOB SITE.
 BUILDING SHALL NOT DEVIATE FROM THE APPROVED PLANS. REQUESTS FOR CHANGES SHALL BE MADE IN WRITING TO THE PERMIT AND RESOURCE MANAGEMENT DEPARTMENT. CHANGES MADE WITHOUT PRIOR APPROVAL SHALL BE SUBJECT TO REJECTION OF THE WORK.
 APPROVAL OF THESE PLANS IS SUBJECT TO, AND DOES NOT AUTHORIZE, DEVIATION FROM COMPLETE COMPLIANCE WITH LOCAL REQUIREMENTS, SPECIAL INSPECTIONS AND 161-1045-AND-FIELD INSPECTION.
 PLEASE READ ALL PERTINENT SECTIONS OF APPLICABLE CODES.

60 HILLCROFT AVE. SUITE B
 SANTA BARBARA, CA 94604
 707 533 6888
 707 533 1837 FAX
 MARCH JOHN MATULICH
 PRINCIPAL
 MJC-Matuli

APPROVAL BY PERMIT AND RESOURCE MANAGEMENT DEPARTMENT IS BASED ON AND LIMITED TO THE FOLLOWING:

1. BUILDING TYPE Office
2. OCCUPANCY GROUP B
3. USE OF STRUCTURE Office @ Juncosly
4. CONTINUOUS INSPECTION PER UBC IS REQUIRED FOR THE FOLLOWING:

Special inspection per CBC 1701 is required for
Welding
Soils

This document has been reviewed and accepted for compliance with the various codes mentioned. Such acceptance does not constitute approval to violate any local, state or federal regulation.
 [Signatures and Dates]

California Building Code	2001 Building Code
California Fire Code	2001 Fire Code
California Mechanical Code	2001 Mechanical Code
California Electrical Code	2001 Electrical Code
California Plumbing Code	2001 Plumbing Code
California Gas Code	2001 Gas Code
California Energy Code	2001 Energy Code

MATULICH ARCHITECTS
 MARCH JOHN MATULICH
 PRINCIPAL
 MJC-Matuli

PROJECT: **VINEYARDS**
 OFFICE: ADDITION
 RUSSIAN HILL ESTATE
 4525 511555E ROAD
 WINDYBARK, CA 97642

SHEET INDEX
 A-1 SITE PLAN
 A-2 FLOOR PLAN, SECTION A-A, CANOPY DETAILS
 A-3 ELEVATIONS, FOUNDATION PLAN & DETAILS, ROOF FRAMING PLAN, ROOF PLAN, SECTION B-B

CONSULTANTS
 STRUCTURAL: ZUCCO PAGENT ASSO. 526-0992
 SOILS: DJC & ASSO. 792-9221
 PAT CONWAY

PROJECT DATA

JURISDICTION: COUNTY OF SONOMA
 APN: 066-280-090
 ZONING: DIVERSE AGRICULTURE
 BUILDING CODE: 2001 CBC, CPC, CMC, CEC
 TYPE OF CONSTRUCTION: V-N, NOT SPRINKLERED
 OCCUPANCY TYPE: B, OFFICE
 ACTUAL AREA: NEW 810 SF, EXISTING 1,055 SF, TOTAL 1,865 SF
 ALLOWABLE AREA: 8,000 SF
 O.L.P. (TABLE 10-A):
 OCCUPANT LOAD:
 REQUIRED EXITS:
 EXITS PROVIDED:

*** APPROVED ***
 AUG 06 2003
 PERMIT AND RESOURCE MANAGEMENT DEPARTMENT

Approval of the following has been deferred:
Energy
DOC
 Design documents for these items shall be submitted to and approved by the Building Official prior to the installation of these items.


OSONOMA COUNTY PERMIT AND RESOURCE MANAGEMENT DEPARTMENT REVIEWED BY [Signature] PERMIT # BLDG-2396 DATE 7-23-03 WELL AND SEPTIC SECTION

PLAN REVIEW ACCEPTANCE BY THE PHILLIPS GROUP CIVIL ENGINEERS SHEETS WHICH HAVE THIS STAMP

RECEIVED JUL 23 2003 THE PHILLIPS GROUP

DEFERRED SUBMITTALS
 TRUSS ENGINEERING
 NOTE: ALL CONSTRUCTION SHALL COMPLY WITH THE 2001 CBC, CPC, CMC, CEC, ALL LOCAL CODES & ORDINANCES.

A-1 OF 3 DATE: 5-15-2003

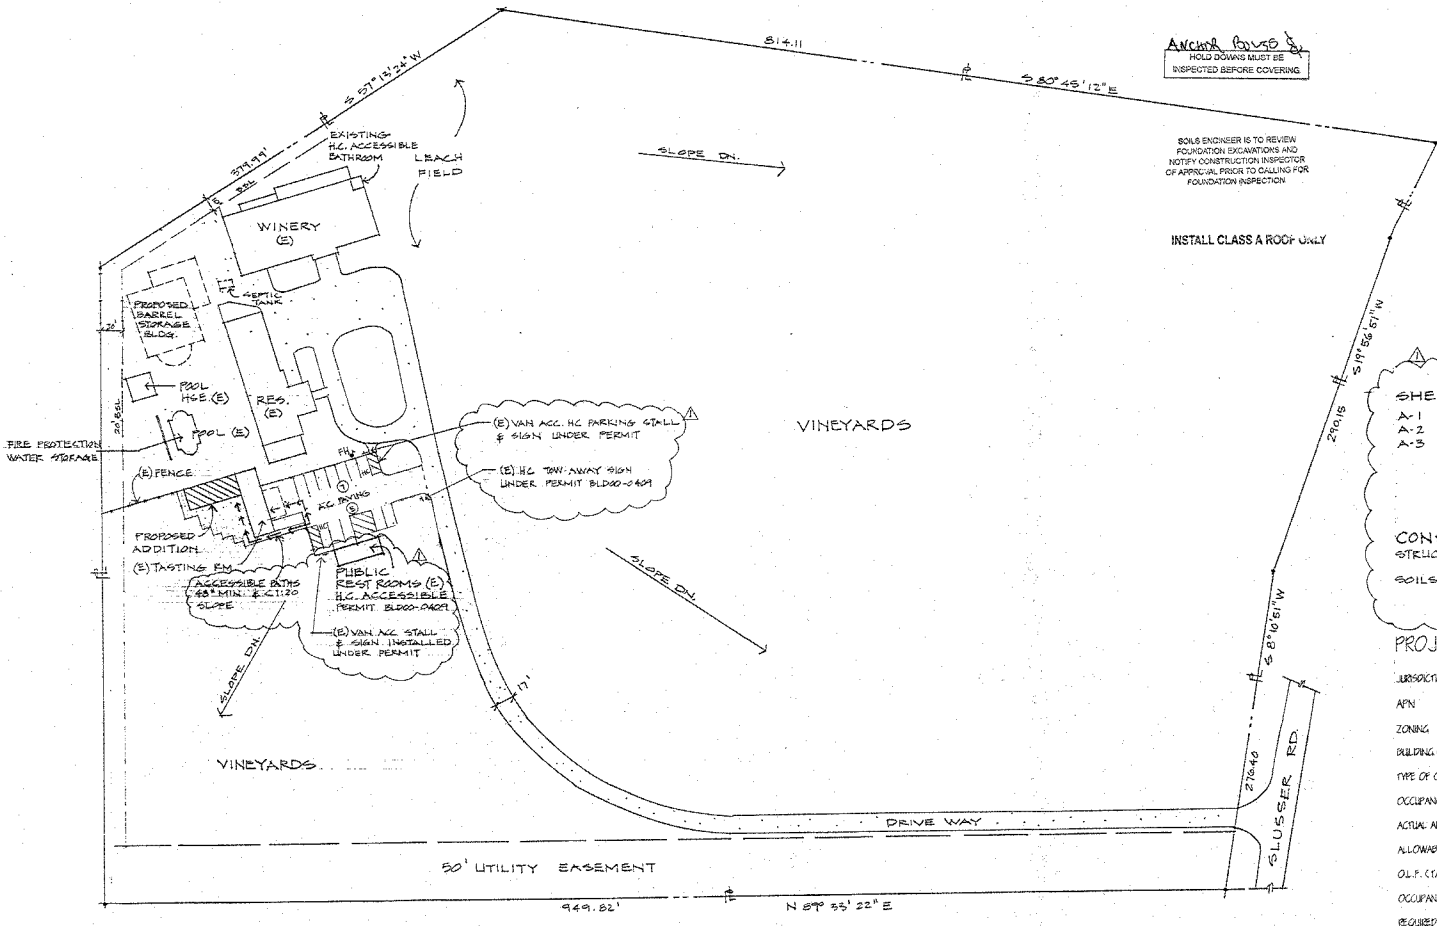

SITE PLAN
 NORTH
 1" = 50'

