

Revisions

IVAN M. LUKRICH
ARCHITECT
P.O. BOX 1642, SANTA ROSA, CA 95402
VOICE 707.573.8291 FAX 707.573.5012

ANVIL RANCH
CARRIAGE HOUSE
NEW RESTROOMS
22303 SKAGGS SPRINGS ROAD
ANNAPOLIS, CALIFORNIA

AS BUILT FLOOR PLAN

Job Number
ANVIL


Drawn By
IML

Scale
1/4" = 1'-0"

Date
3-4-2020


Sheet Number

A1
of

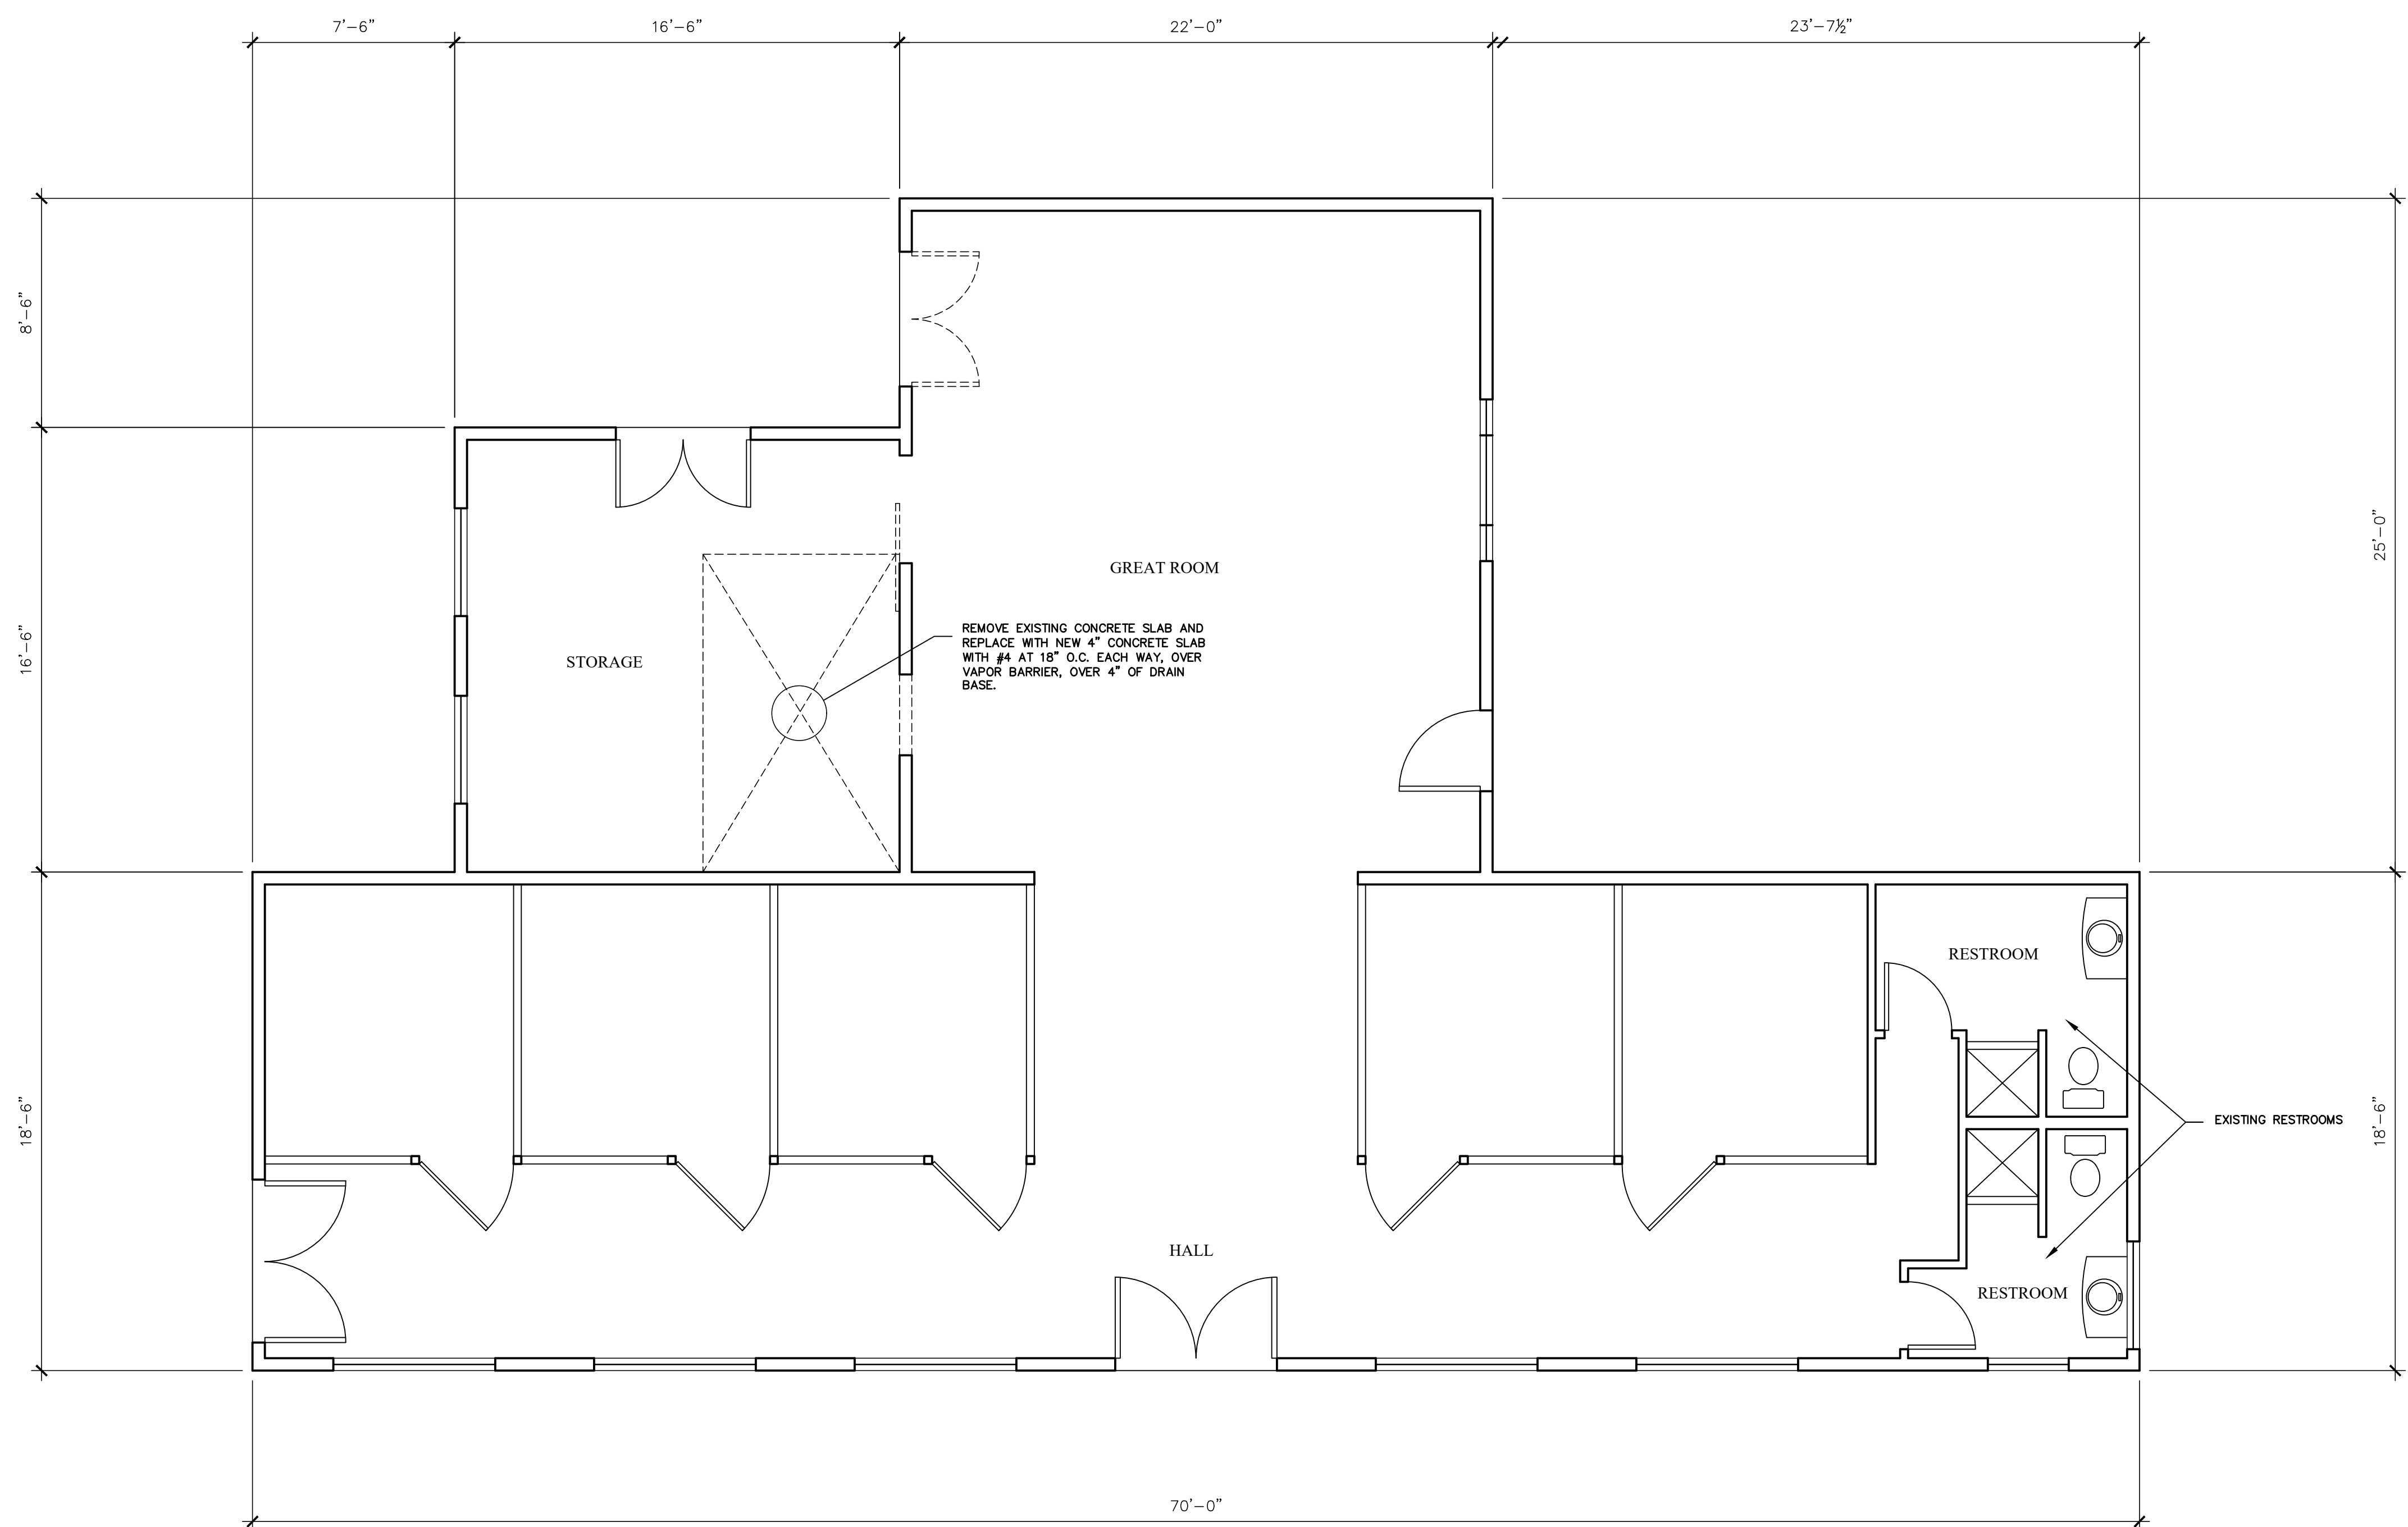

AS BUILT - DEMOLITION PLAN

WALL LEGEND
 [Solid Line] EXISTING WALLS
 [Dashed Line] WALLS AND DOORS TO BE DEMOLISHED

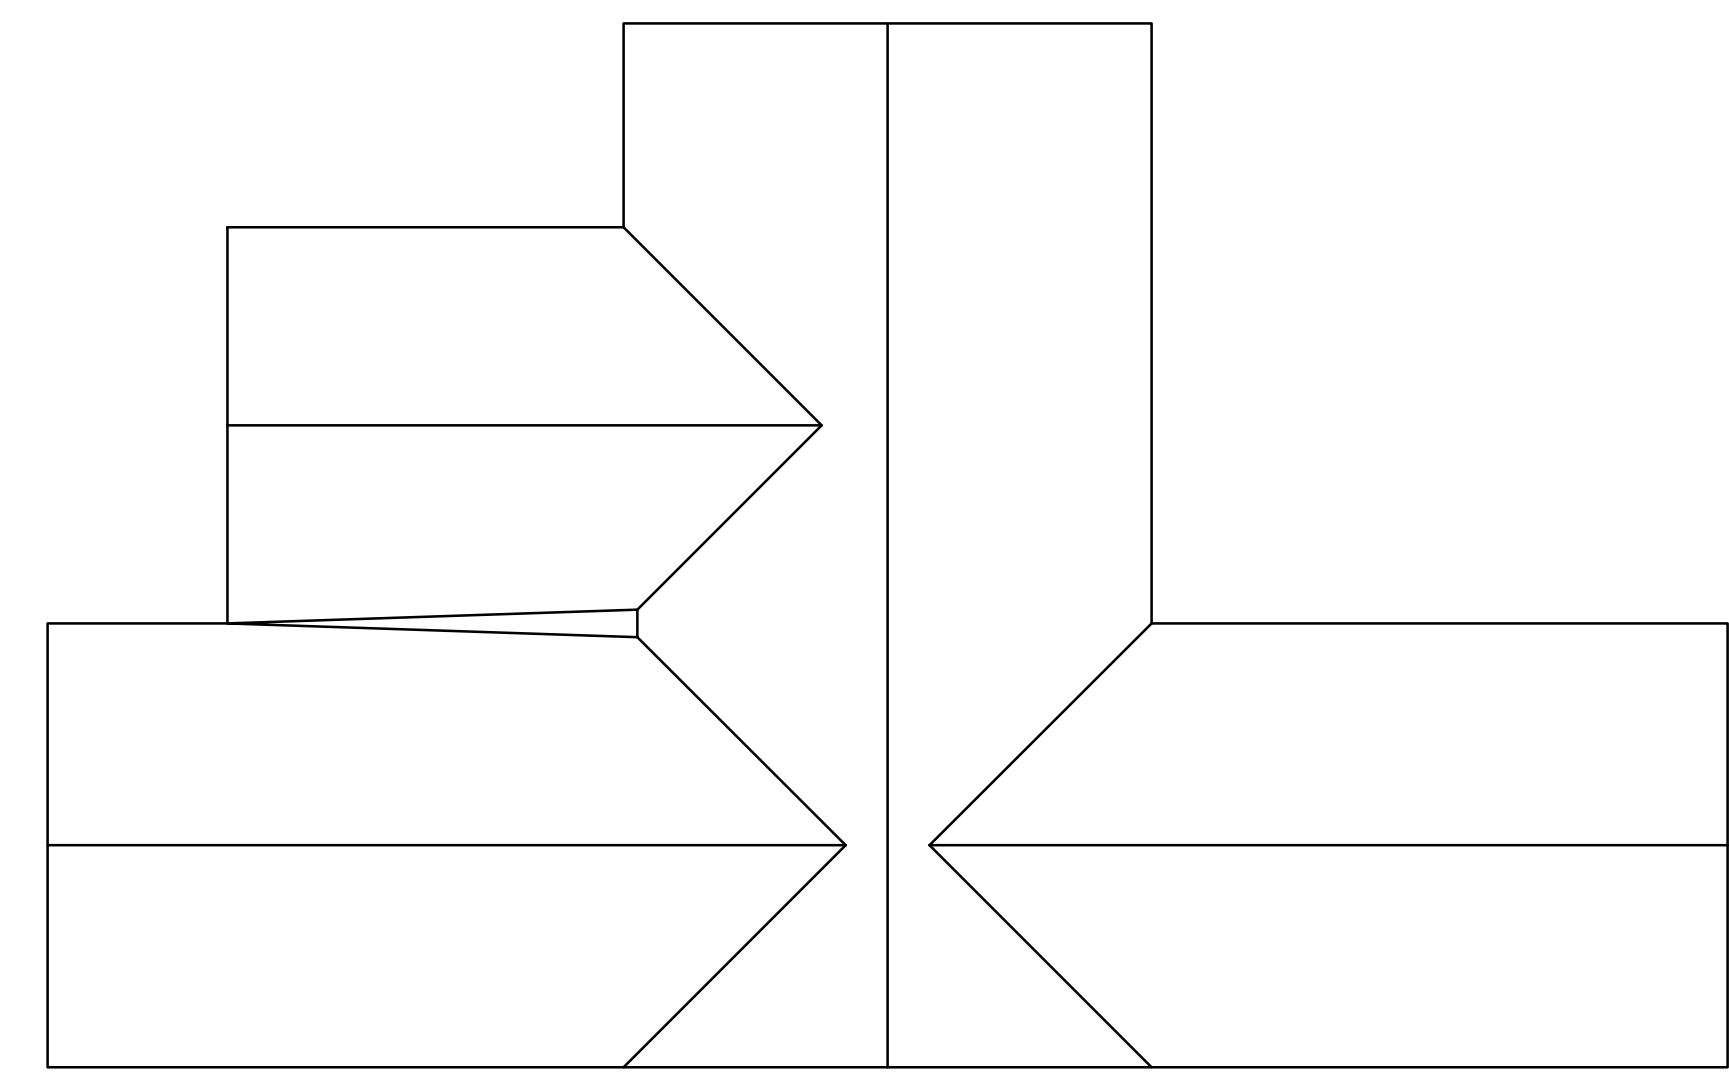

ROOF PLAN