


THIS DOCUMENT AND THE IDEAS AND DESIGNS INCORPORATED HEREIN, AS AN INSTRUMENT OF PROFESSIONAL SERVICE, IS THE PROPERTY OF STEVE MARTIN ASSOCIATES, INC. AND IS NOT TO BE USED IN WHOLE OR IN PART, FOR ANY OTHER PROJECT WITHOUT THE WRITTEN AUTHORIZATION OF STEVE MARTIN ASSOCIATES, INC. © 2023

[S:\2023\2023006 Manzana\Encroachment Permit\2206-ENC-C20 A-B.dwg-LayoutC20
SAVED BY: Brea , 6/18/2024 11:06 AM

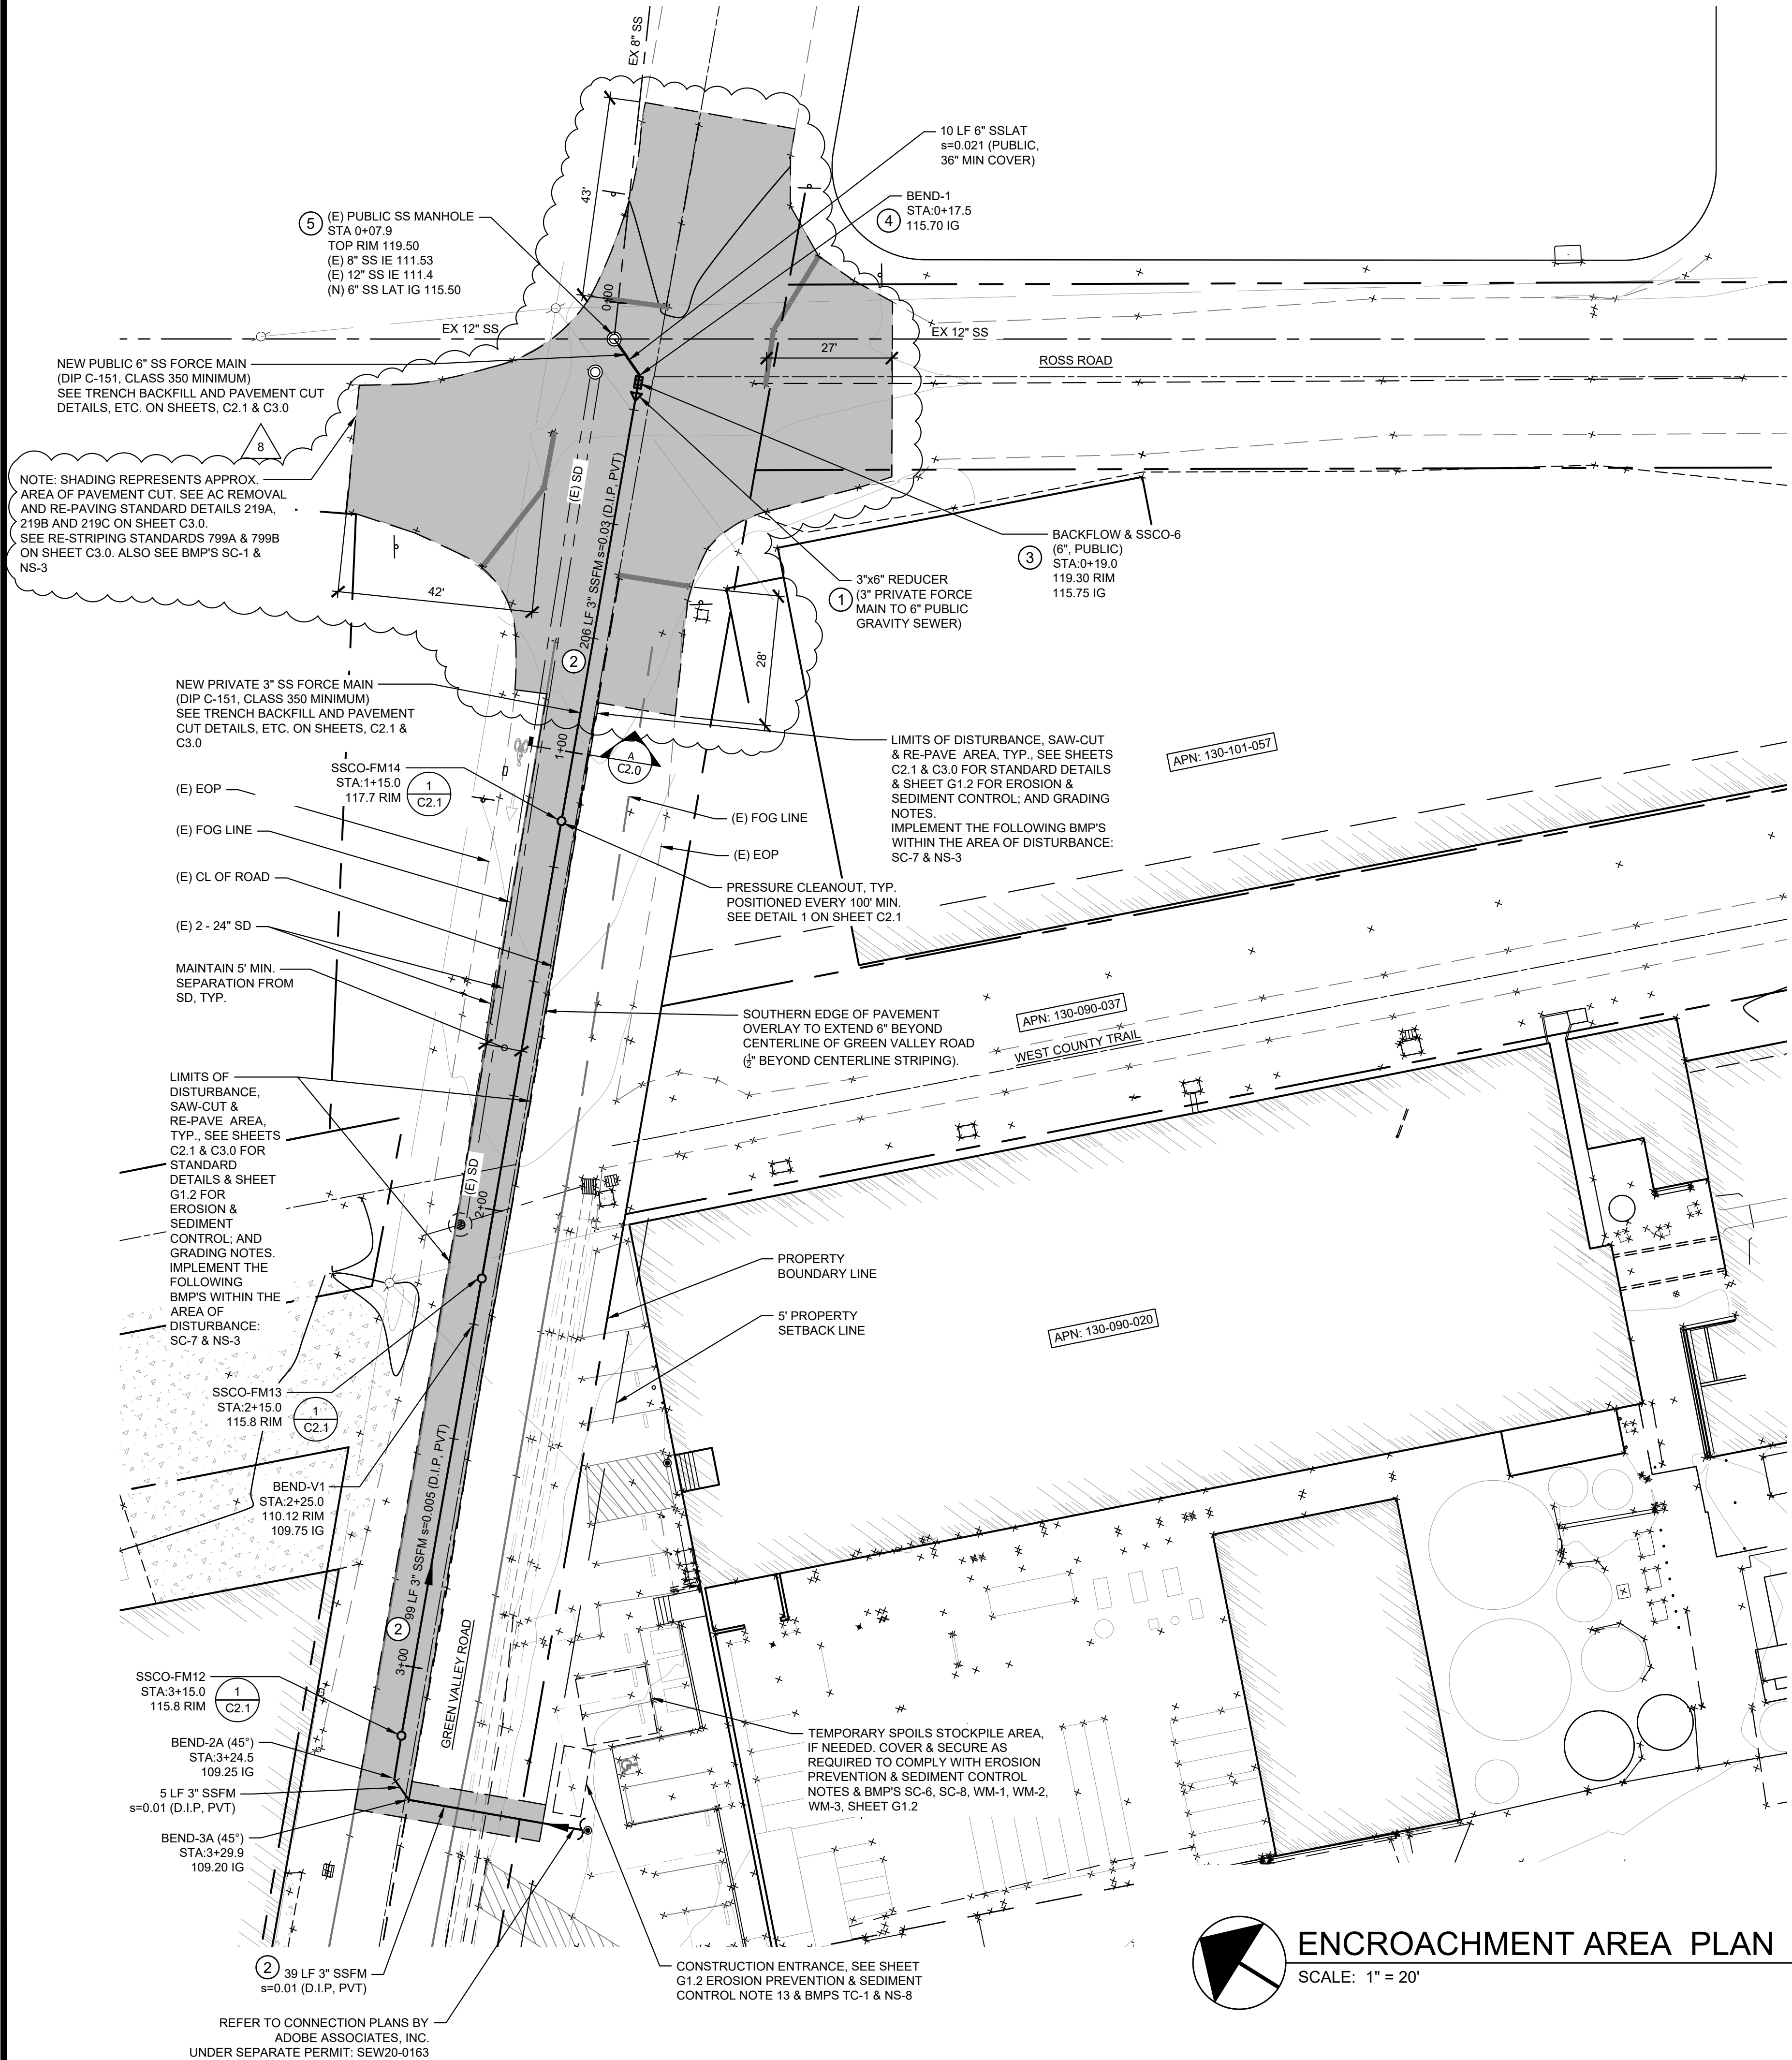

KEY NOTES:


- DISCHARGE FOR PRIVATE FORCE MAIN, SCWA STD. DWG-128, SHEET C2.1
- SANITARY TRENCHING, SCWA STD. DWG-107, 108 & 133 (36" MIN PIPE COVER, TYP), SHEET C2.1
- SANITARY SEWER BACKFLOW CHECK VALVE, SCWA STD. DWG-127, SHEET C2.1
- THRUST BLOCK, COUNTY WATER STD DWG. 204 & 205, SHEET C3.0
- CONNECT NEW 6" SEWER TO EXISTING SEWER MANHOLE PER SCWA STD. DWG-101, SHEET C2.1

NOTES:

- FOR PROFILE OF WORK PERFORMED IN THE RIGHT OF WAY, SEE SHEET C4.0
- FOR TRAFFIC CONTROL PLAN AND STANDARD DETAILS, SEE SHEETS TCP1 & TCP2.

NOTES:

- 0.15' MIN. OVERLAY SHALL EXTEND FROM EXISTING BIKE/FOG LANE TO 6" BEYOND EXISTING CENTERLINE OF GREEN VALLEY ROAD (1/2" BEYOND SOUTHERLY CENTERLINE STRIPE).
- PRIOR TO OVERLAY, THE SLURRY TRENCH SHALL BE RE-SAWCUT OR GROUND 3" EACH SIDE OF TRENCH SIDEWALLS. THIS AREA OF FULL-DEPTH AC REPLACEMENT SHALL BE PAVED TO A MIN. DEPTH OF 0.45' OR MATCH THICKNESS OF THE EXISTING PAVEMENT, WHICHEVER IS GREATER.
- FOR ADDITIONAL DETAIL AND INFORMATION ON RESTORATION WORK SEE COUNTY OF SONOMA STANDARD DRAWING NO. 219, SHEET C3.0

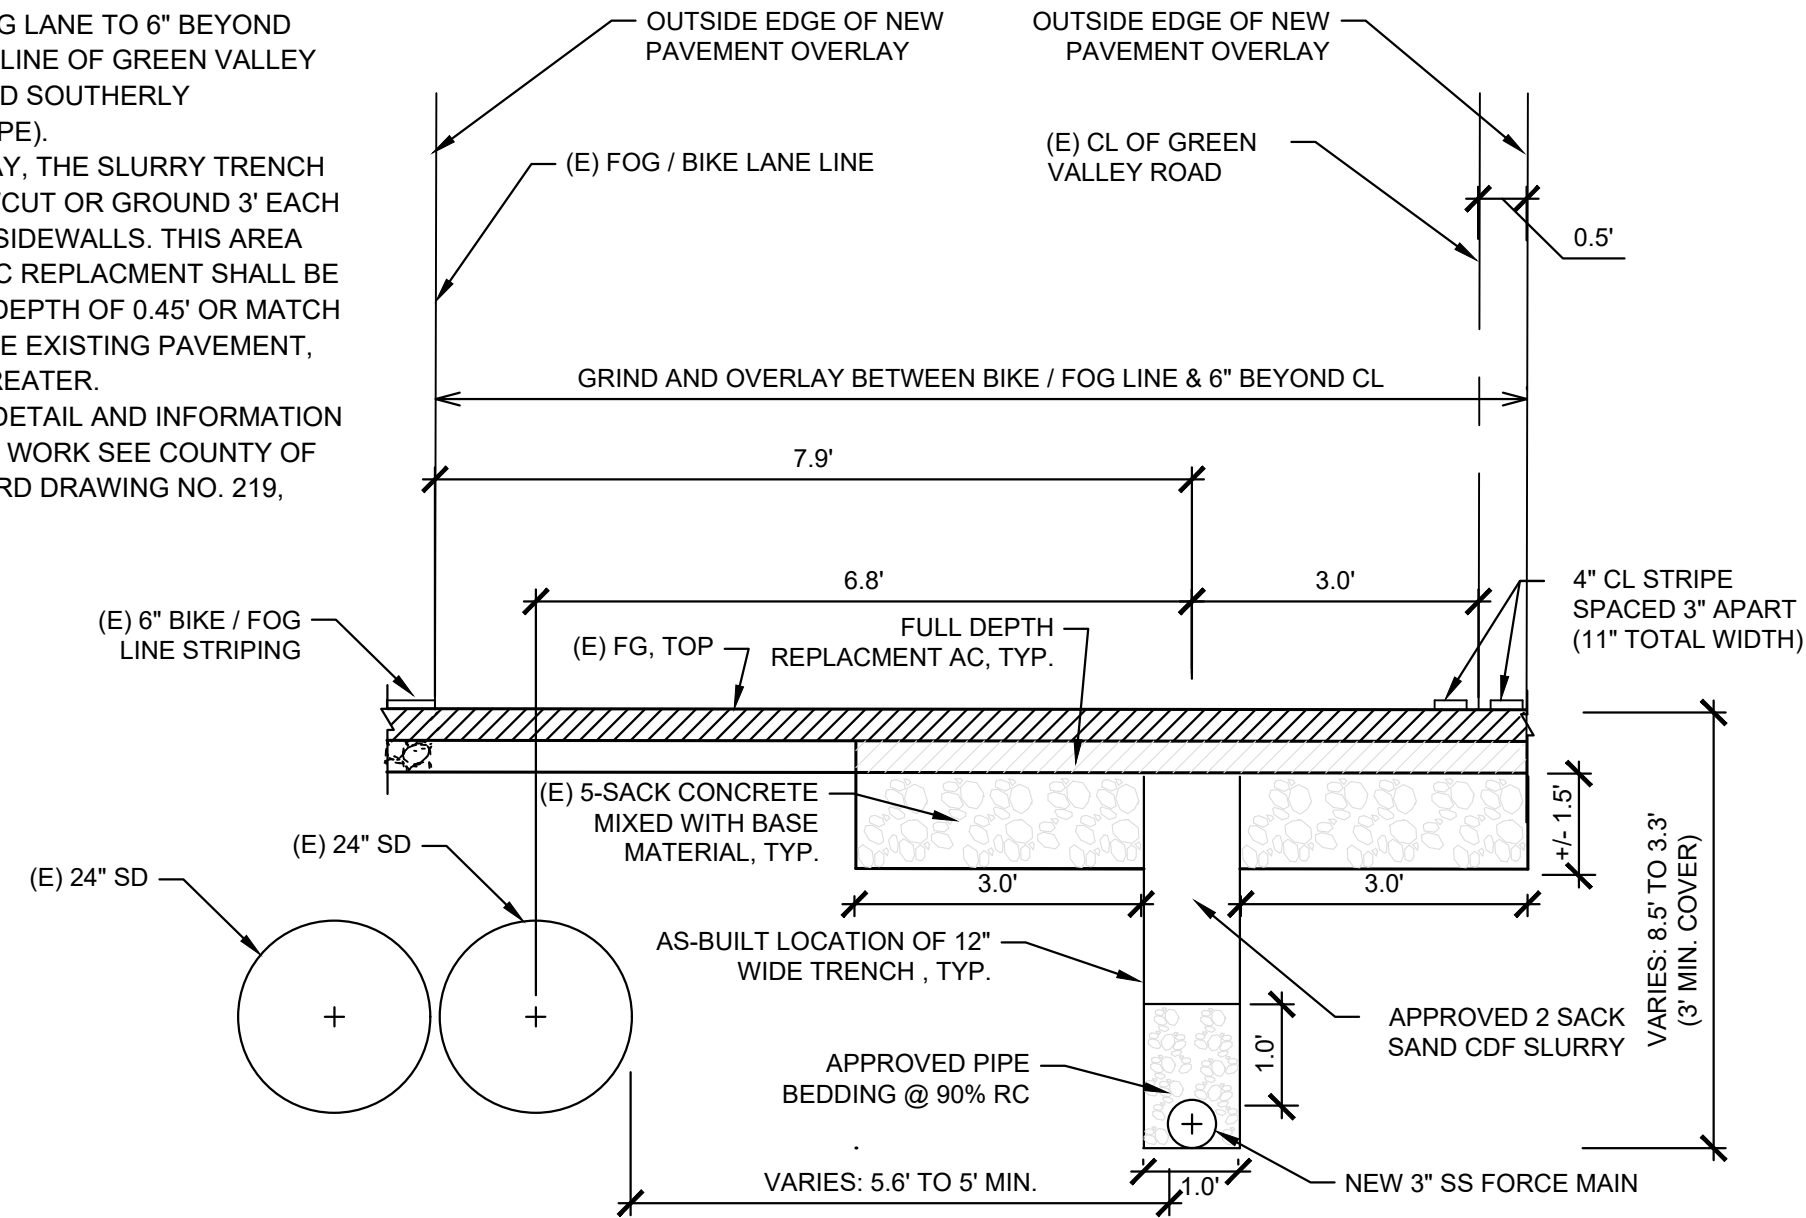

AS-BUILT
6-18-2024

SMA
Steve Martin Associates

130 S. Main Street, Ste 201
Sebastopol, CA 95472
(707) 824-9730
Fax (707) 824-9707

www.SMAAssociates.net



ENCROACHMENT PERMIT

ENCROACHMENT
AREA PLAN

MANZANA PRODUCTS, INC.
9141 Green Valley Rd.
Sebastopol, CA 95472
APN: 130-090-020

REVISIONS

DATE	DESCRIPTION
5/15/23	REISSUED
6/8/23	PLAN CHECK COMMENTS
7/19/23	PLAN CHECK COMMENTS
8/17/23	PLAN CHECK COMMENTS
10/12/23	REISSUED
11/20/23	PIPE MATERIAL
12/18/23	PLAN CHECK COMMENTS
01/05/24	PLAN CHECK COMMENTS
03/27/24	EXCEPTION REQUEST
06/18/24	AS BUILT-PAVED AREA

JOB NO. SMA-2022006

DATE FEBRUARY 2, 2023

DRAWN JT CHKD SM

FILE NO. 2206-ENC-C20 A-B

SHEET

C2.0

PERMIT#: ENC23-0033